STATE OF UTAH
OFFICE OF STATE ENGINEER

HYDROGRAPHIC SURVEY
UINTAH BASIN, UINTAH COUNTY
SHEET 163a

proposed 9/74

NW1/4 + N1/2 SW1/4 Sec 8
NE1/4 + N1/2 SE1/4 Sec 7 — Sheet 163aa
Blown up 1"=200'

Sheet 163-a

1. United States of America
2. Uintah County
3. N. J. Meagher
4. ~~F. H. Hopkins~~ Don Cook
5. Dell Gene & Ellen R. Cook
6. Harold A. Cook
7. ~~Charles D. Slaugh~~ Slaugh + Sons
8. Hyrum W. Slaugh
9. ~~Robert Cook~~ Floyd Cook
10. ~~Edgar C. Jones~~ Glen Cook
11. Hy Slaugh
12. Ritchie Stubbs
13. ~~Lynn Richens~~ Hugh Richens
14. John C. Brewer
15. ~~M. Clark Feltch, et ux~~ Ken + Shela Lind
16. Moon Lake Electric Assn. Inc.
17.
18. Enos & David Bennion
19. Elijah & Mae Jackson
20. ~~Arthur M. Boren et ux~~ Dana Jackson
21. L. D. S. Church
22. Marvin Jackson
23. Joe B. & Kate V. Lopez
24. Oscar L. & Mev. Majors
25. Shirley Cook
26. ~~Tommy Atwood~~ Kenneth + Connie Holmes
27. Sidney G. Calder
28. Uintah Stake LDS Church
29. ~~Kenneth G. Barker~~ Westout Patsy Serrano
30. ~~F. H. Hopkins~~
31. School Dist. No. 10
32. Vera Gurr
33. Pearl Chivers
34. ~~Benjamin F. Johnson~~ Paul + Barbara Caldwell
35. Marlo Z. & Leona G. Bowthorpe
36. Davis Ward LDS Church
37. ~~Orvell R. Oaks~~ Arvel + Elaine Oaks
38. Hyrum H. & Nordise Greenhow
39. Lyle Slaugh
40. Cecil A. & Bulia C. Pummell
41. Shirley & Delma Walkins
42. ~~Lorenzo & Jennie Watkins~~ Clifford + Delaine Massey
43. ~~Glyde & Lovina Chivers~~ Slaugh Bros. Cement
44. Shirley D. & Elizabeth K. Cook
45. Bill & Reba Serano
46. Glade B. & Laverta Cook
47. ~~Marinal~~ Chivers, Leora
48. Bill Serrano & Belva Serrano
49. A. Allen Bennion
50. Margaret F. Price
51. Orson & Rosalie Burton
52. John K. Abplanalp
53. Alfred Simper
54. Paul D. C ldwell
55. Patrick & Wanda Rae Lopez
56. W. F. Sharp
57. Bill Mead et ux
58. ~~Evan D. Perry~~ Vernal Congregation of Jehovahs Witnesses
59. R. J. Slaugh + Wade Slaugh
60. ~~Nolan R. Slaugh~~ Gregg + Wann Leachman
61. ~~Grant Johnson~~ Kerry + Marquaita Bowthorpe
62. ~~Brice D. Searle~~ Dan + Carma Elli Fritz
63. Neldon B. Slaugh
64. Don & Anita O'Driscoll
65. Dorothy Stubbs

Sheet 163a

66. Danny Cook
67. Lane Jackson et.ux.
68. Floyd & Sarah Cook
69. Dell & Joyce Johnson
70. James & Lilly Spain
71. Production Logging Service Inc.
72. Billie Floyd Cook et.ux.
73. Dal Cook et.al.
74. Terry & James Latham
75. Raymond Sheflett et.ux.
76. Rock Hall
77. Vickie & Clayton Allred
78. Robert & Eloise Turner
79. Cline Barker
80. John & Marian Berber
81. Clifford & Maxine Hershey
82. Darla & Kenneth Judd
83. Brad Stiegelmeyer et.ux.
84. Charles & Nita Powell
85. Kathy & Michael Laris
86. Jeffery & Connie Licht
87. Bill & Carla Allen
88. Rodney & Pauline Hauer
89. Sarah Cook
90. David Wambolt et.ux.
91. Eddie & Sonstance Hoff
92. Ronald Westwood et.ux.
93. Dayrl Colton
94. Brownie Tomlinson
95. Roger Bahls
96. William Littrell
97. Delmore Atwood et.ux.
98. Clayton Slaugh
99. Burnell Slaugh
100. Lee Slaugh
101. James Montgomery
102. Boyd Dillon
103. Boyd & Sharon Dillon
104. Neils Wright
105. Bryce Slaugh
106. Ronald James, et.ux.
107. Russell Anderson
108. Karl & LaRae Baese
109. Sandy Atwood
110. Willis Akelund
111. Clark & Cleo Mortenson
112. Roger Harrison

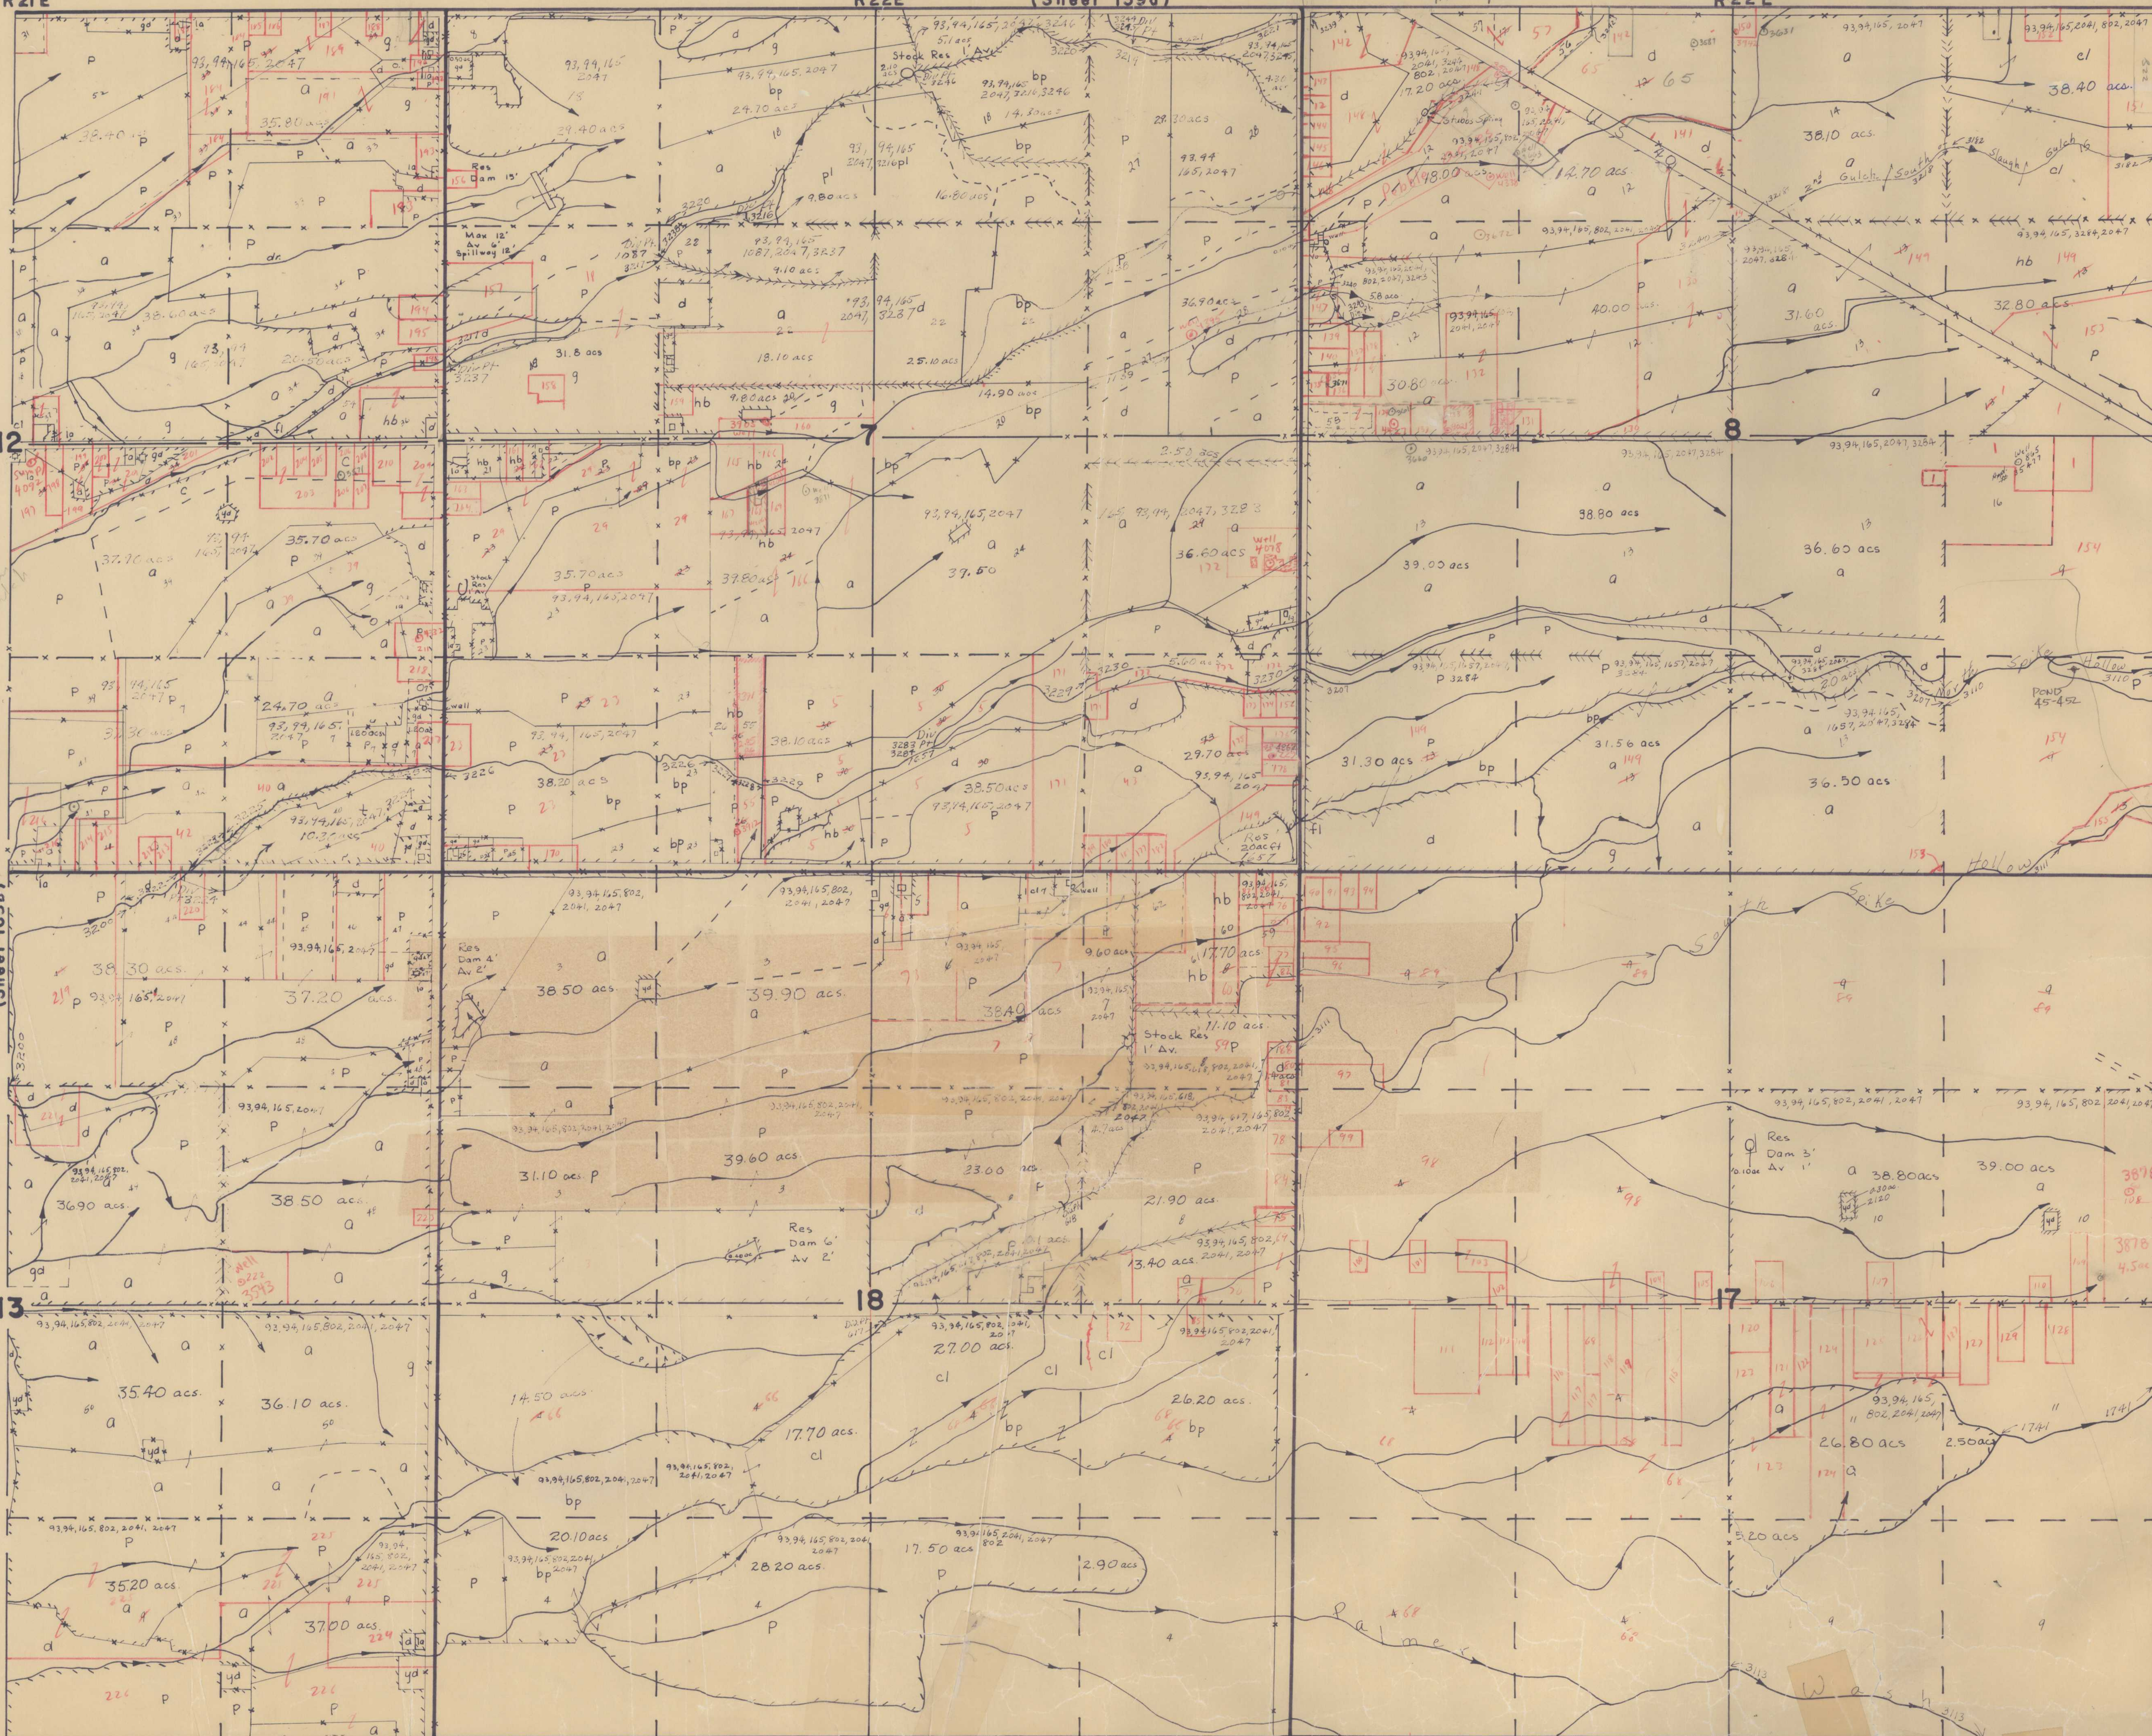

Field Engineer, R. Guy
Assistants, J. Hadley, W. Daynes
Traced by W. Kiyota

Scale 1 Inch = 500 Feet
Surveyed 1959
Traced 1960

Sheet 163a